




REVISÉ



04.	19-11-2024	AS BUILT	
03.	21-02-2024	MINOR REVISION [ELEVATION]	
02.	26-10-2023	MINOR REVISION [ELEVATION]	
01.	16-08-2023	MINOR REVISION IN COL.&WINDOW	
REV.	DATE	DESCRIPTION	BY

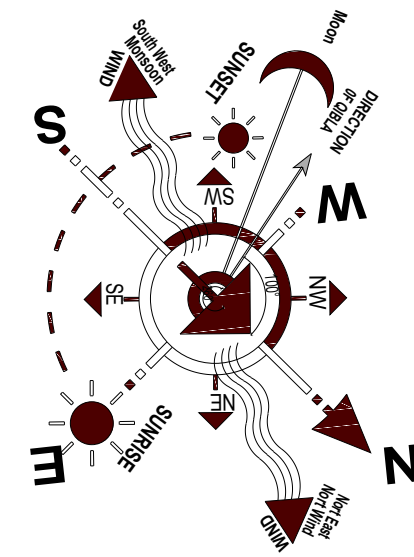

PROJECT OWNER:

SHANA ABDUL LATIF.

JOB TITLE :

PRIVATE RESIDENTIAL VILLA.
[B.+G.+1.+R.]

PLOT NO. / PARCEL ID	BLOCK:
3323831 [SB-28.]	LA MER

DRAWING:

BASEMENT FLOOR PLAN

TITLE : JOB NO. :		936.	
ARCHITECT :	STRUCTURAL ENGR :	DRAWN :	
ENG.ISMAIL H.S.	ENG.SYED AHMED.	RAJ.	
SCALE :	DATE :	CHECKED BY :	
	APRIL/2024.		
SHEET SIZE :	DRG.NO.	SH.NO.	REVISION NO. :
A2	A-101A		04.

ANY INCONSISTENCY OR DISCREPANCY IS TO BE BROUGHT TO THE ATTENTION OF & RESOLVED BY THE CONSULTANT & BEFORE THE WORK IS PUT IN HAND.

- * All trees are offset by a minimum of 1m. from the boundary
- * All planting within the 3m. planting zone shall be no higher than 1.8m.
- * Ornamental species with low irrigation requirements are recommended to be used in this zone.
- * A minimum of 30% of the zone shall be covered by recommended planting.




RENAISSANCE
 ENGINEERING CONSULTANTS
 P.O. Box No.129446, Tel. 01-26797162; E-mail: rena001@emj.az
 Mohammed El Rashid Al Matrouk Hammad El Chahy At Al Mansour, Teheran

SHANA ABDUL LATIF.

PRIVATE RESIDENTIAL VILLA.
[B.+G.+1.+R.]

DRAWING:


TITLE: _____
JOB NO. 936

ARCHITECT :	STRUCTURAL ENGR :		DRAWN :
ENG.ISMAIL H.S.	ENG.SYED AHMED.		RAJ.
SCALE:	DATE:		CHECKED BY :
	APRIL/2024.		
SHEET SIZE :	DRG.NO.	SH.NO.	REVISION NO. :
A2	A-102A		04.



Note:- Parking all guidelines sand requirement should follow relevant Authorities unless otherwise specified.

GROUND FLOOR PLAN

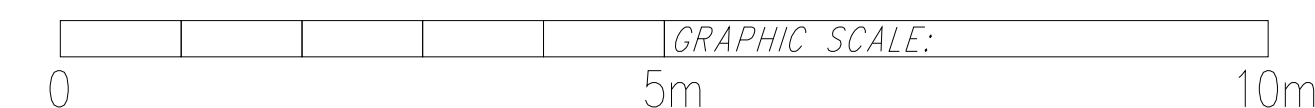


SCALE:- 1:100

DRAWINGS ARE NOT TO BE SCALED, STATED
DIMENSIONS ONLY ARE TO BE TAKEN.

ANY INCONSISTENCY OR DISCREPANCY IS TO BE BROUGHT TO THE ATTENTION OF & RESOLVED BY THE CONSULTANT & BEFORE THE WORK IS PUT IN HAND.

COPY OF APPROVED ELECTRONIC DOCUMENTS ISSUED WITHOUT
SIGNATURE BY DUBAI DEVELOPMENT AUTHORITY

DDA.GOV.AE

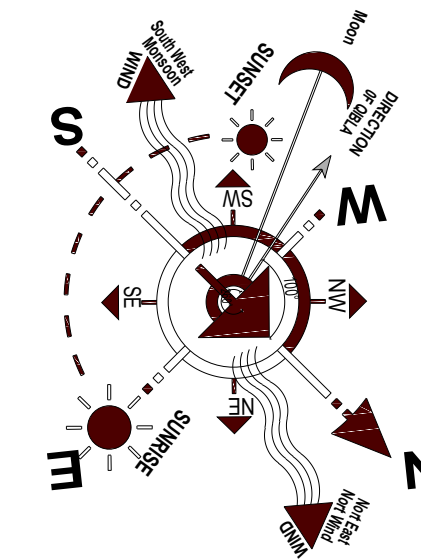

Handwritten signature: *Shahzad*
 P.O.Box 124548
 DUBAI - U.A.E.
 PERMANENCE ENGINEERING COMPANY


RENAISSANCE
 ENGINEERING CONSULTANTS
 P.O. Box 104548, Tel. 04-5258442, E-mail: renco@rednet.net
 Mohammed Bin Rashid Al Maktoum International & Shafiqi Est. Al Maktoum, Dubai

SHANA ABDUL LATIF

PRIVATE RESIDENTIAL VILLA
[B.+G.+1.+R.]

PLOT NO. / PARCEL

ROOF FLOOR PLAN.

ARCHITECT :	STRUCTURAL ENGR :	DRAWN :
ENG. JAMAL M. S.	ENG. SAUD ALMUTAIRI	SAH

SCALE:	DATE:	CHECKED BY :
	APRIL 2004	


SHEET SIZE :	DRG.NO.	SH.NO.	REVISION NO. :
--------------	---------	--------	----------------

A2	A-104A		04.
----	--------	--	-----



SCALE:- 1:100

ROOF FLOOR PLAN

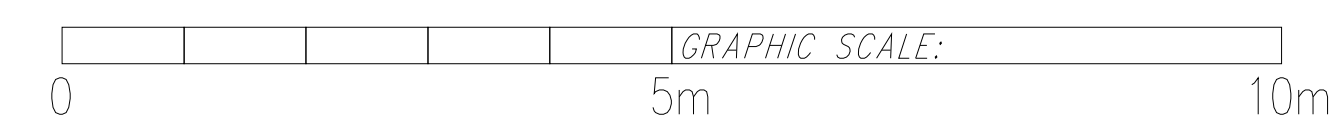



LEFT SIDE ELEVATION.



RIGHT SIDE ELEVATION.

سلطة دبي للتطوير

Dubai Development Authority

02203756

REQ-1644845

22-Jan-2025

NO OBJECTION

COPY OF APPROVED ELECTRONIC DOCUMENTS ISSUED WITHOUT SIGNATURE BY DUBAI DEVELOPMENT AUTHORITY

DDA.GOV.AE

ES :

THIS DRAWING MAY NOT BE REPRODUCED BY ANY MEANS WITHOUT PRIOR APPROVAL FROM RENAISSANCE ENGINEERING CONSULTANTS

2. DRAWINGS ARE NOT TO BE SCALED, STATED DIMENSIONS ONLY ARE TO BE TAKEN.

ANY INCONSISTENCY OR DISCRIPANCY IS TO BE BROUGHT TO THE ATTENTION OF & RESOLVED BY THE CONSULTANT & BEFORE THE WORK IS PUT IN HAND.

REVISED

RENAISSANCE

ENGINEERING CONSULTANTS

PROJ. NO. 12845
DUBAI - U.A.E.

04.	19-11-2024	AS BUILT	
03.	21-02-2024	MINOR REVISION (ELEVATION)	
02.	26-10-2023	MINOR REVISION (ELEVATION)	
01.	16-08-2023	MINOR REVISION IN COL & WINDOW	
REV.	DATE	DESCRIPTION	BY

PROJECT OWNER:

SHANA ABDUL LATIF.

JOB TITLE :

PRIVATE RESIDENTIAL VILLA.
[B.+G.+1.+R.]

PLOT NO. / PARCEL ID

BLOCK:

3323831 [SB-28.]

LA MER

DRAWING:

PERSPECTIVE BACK&LEFT SIDE.

TITLE:

JOB NO.

936.

ARCHITECT :	STRUCTURAL ENGR :	DRAWN :	
ENG.ISMAIL H.S.	ENG.SYED AHMED.	RAJ.	
SCALE:	DATE:	CHECKED BY :	
	APRIL/2024.		
SHEET SIZE :	DRG.NO.	SH.NO.	REVISION NO. :
A2	G-102A.		04.



 مملكة دبي Emirate of Dubai	سلطنة دبي للتطوير Dubai Development Authority	ES :
B2203756	REQ. 1644845	THIS DRAWING MUST NOT BE REPRODUCED BY ANY MEANS WITHOUT PRIOR APPROVAL FROM RENAISSANCE ENGINEERING CONSULTANTS
22 Jan 2026	NO OBJECTION	2. DRAWINGS ARE NOT TO BE SCALED, STATED DIMENSIONS ONLY ARE TO BE TAKEN. 3. ANY INCONSISTENCY OR DISCREPANCY IS TO BE BROUGHT TO THE ATTENTION OF & RESOLVED BY THE CONSULTANT & BEFORE THE WORK IS PUT IN HAND.
COPY OF APPROVED ELECTRONIC DOCUMENTS ISSUED WITHOUT SIGNATURE BY DUBAI DEVELOPMENT AUTHORITY		
DAA.GOV.AE		

REVISED

04.	19-11-2024	AS BUILT	
03.	21-02-2024	MINOR REVISION [ELEVATION]	
02.	26-10-2023	MINOR REVISION [ELEVATION]	
01.	16-08-2023	MINOR REVISION IN COL.&WINDOW	
REV.	DATE	DESCRIPTION	BY


RENAISSANCE
 ENGINEERING CONSULTANTS
 P.O. Box 9424541 Tel: 0425298822 Jorid: 10000000-04
 Mohamed El-Rashed Al-Masri (Renaissance) & Co. Ltd. All Member, T-10

PROJECT OWNER: SHANA ABDUL LATIF.

JOB TITLE : PRIVATE RESIDENTIAL VILLA.
[B.+G.+1.+R.]

PLOT NO. / PARCEL ID	BLOCK:
3323831 [SB-28.]	LA MER

DRAWING: _____

PERSPECTIVE FRONT SIDE.

TITLE: JOB NO.		936.	
ARCHITECT :	STRUCTURAL ENGR :		DRAWN :
ENG.ISMAIL H.S.	ENG.SYED AHMED.		RAJ.
SCALE:	DATE:		CHECKED BY :
	APRIL/2024.		
SHEET SIZE :	DRG.NO.	SH.NO.	REVISION NO. :
A2	G-101A.		04.